

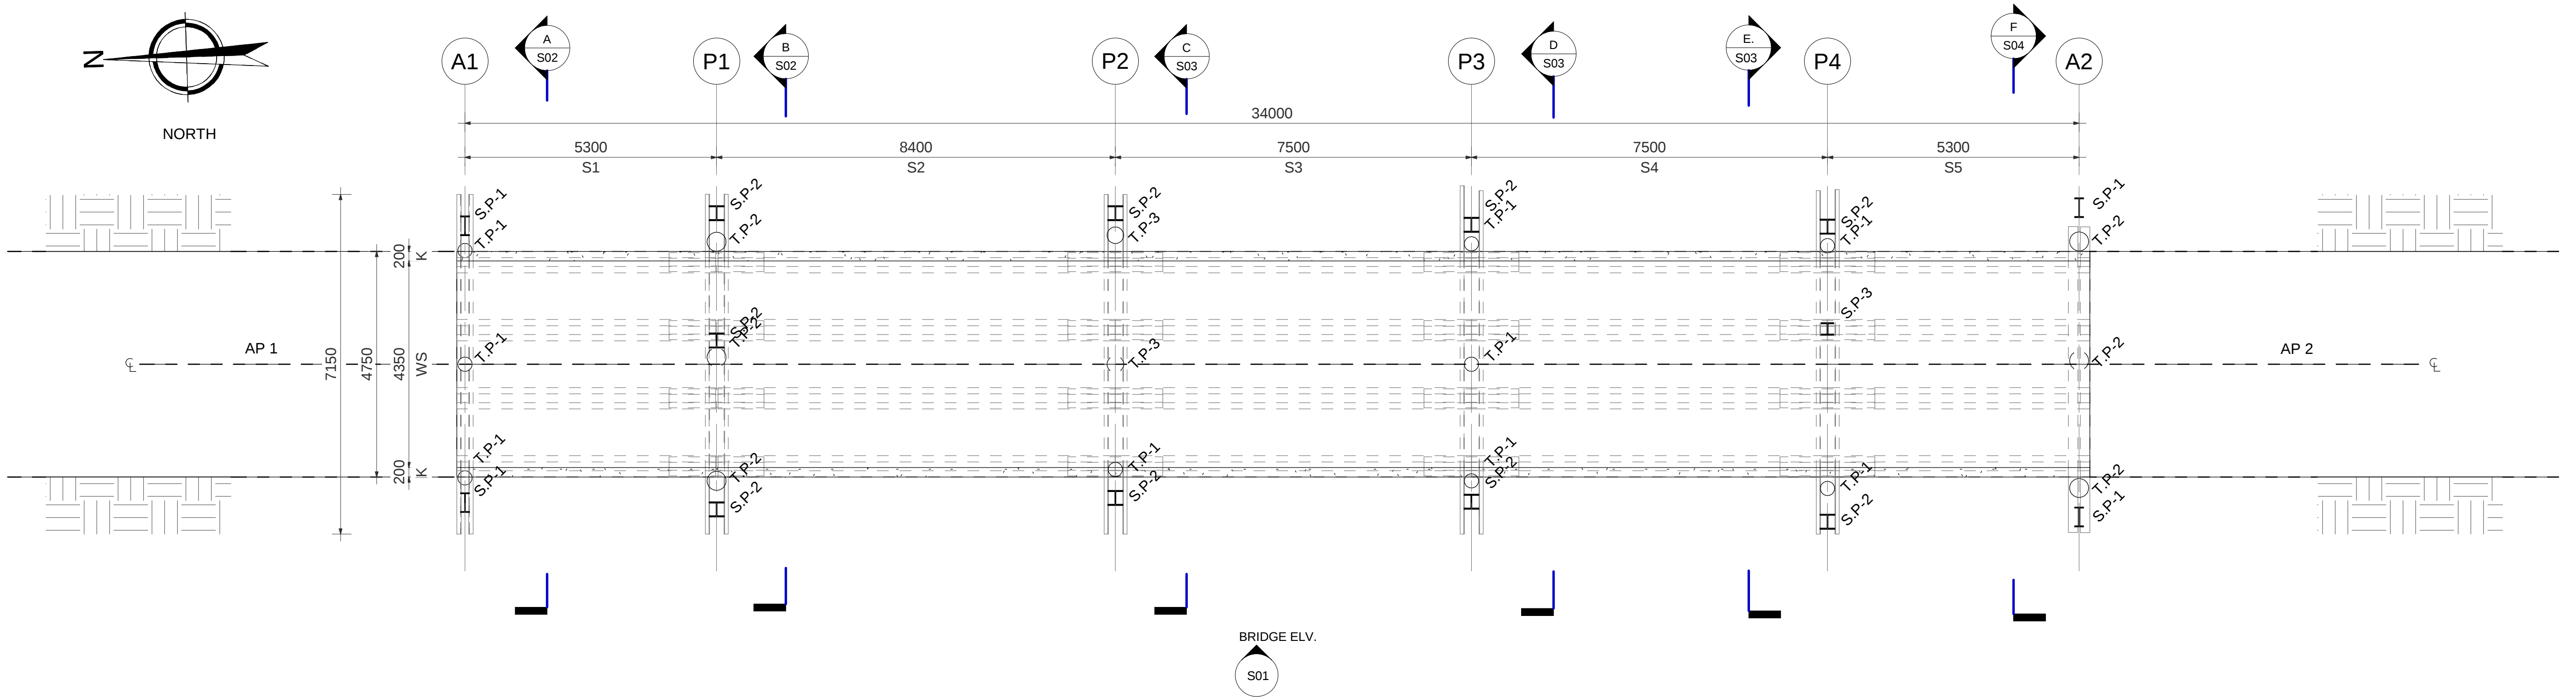


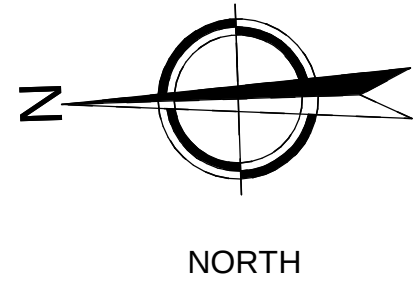

BRIDGE PLAN

SCALE 1 : 75

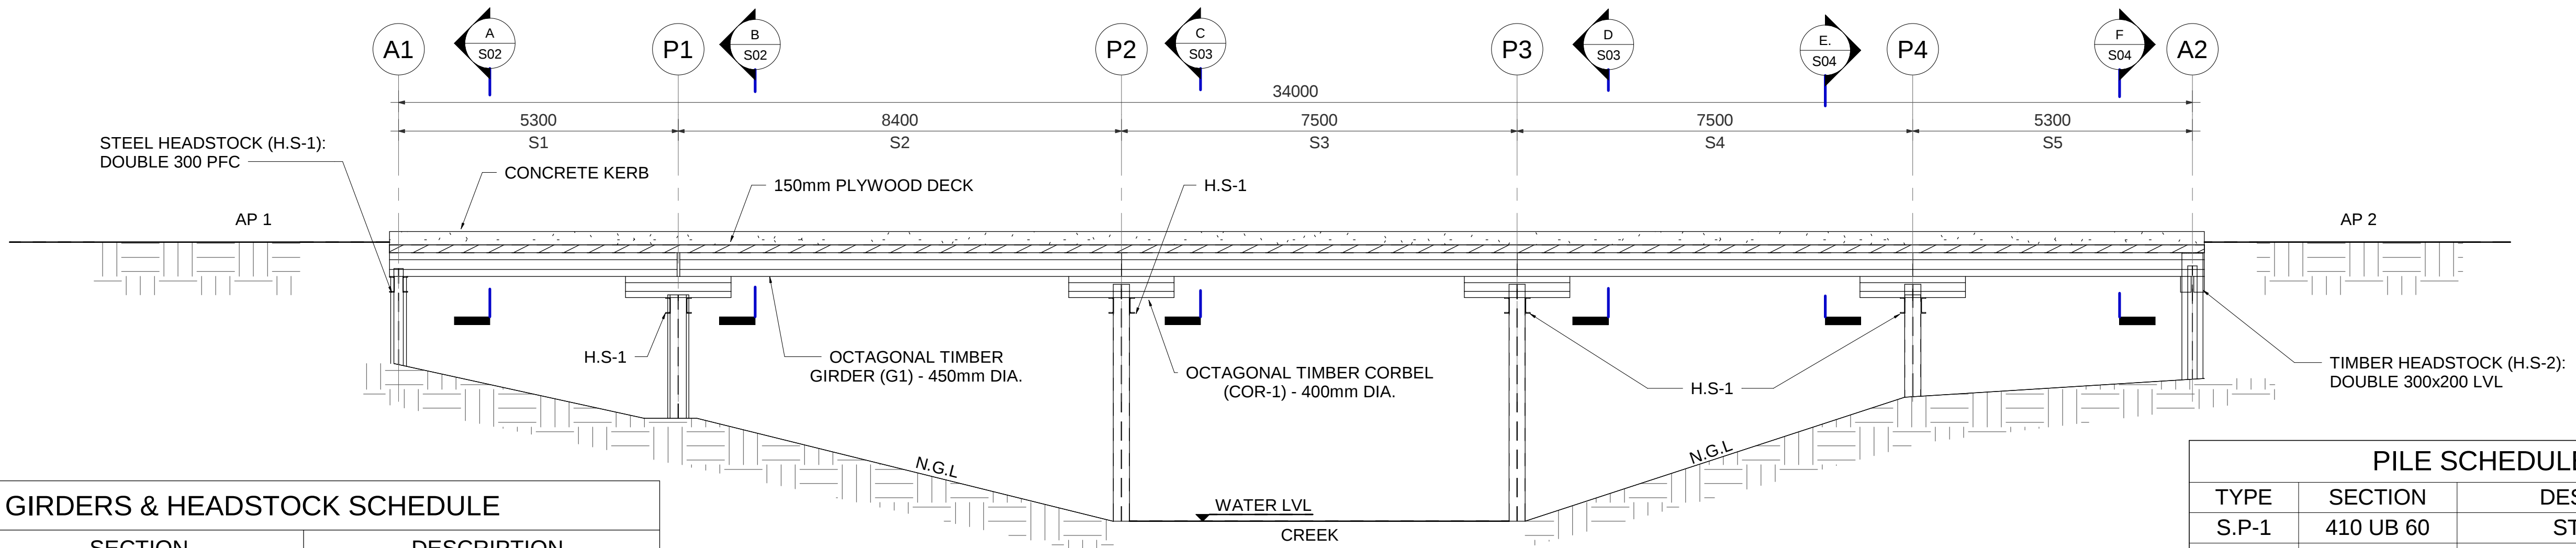

GIRDERS & HEADSTOCK SCHEDULE

TYPE	SECTION	DESCRIPTION
G1	450mm DIA. OCTAGON	TIMBER GIRDER @1433mm
COR-1	400mm DIA. OCTAGON	TIMBER CORBEL @1433mm
H.S-1	DOUBLE 300 PFC	STEEL HEADSTOCK
H.S-2	DOUBLE 300x200 LVL	TIMBER HEADSTOCK
BR-1	DOUBLE 230 PFC	STEEL BRACING
BR-2	DOUBLE 150x75 LVL	TIMBER BRACING
WL-1	DOUBLE 150 PFC	STEEL WALE
WL-2	DOUBLE 230 PFC	STEEL WALE
WL-3	DOUBLE 170x75 LVL	TIMBER WALE

PILE SCHEDULE

TYPE	SECTION	DESCRIPTION
S.P-1	410 UB 60	STEEL PILE
S.P-2	310 UC 97	STEEL PILE
S.P-3	250 UC 73	STEEL PILE
T.P-1	Φ300mm	TIMBER PILE
T.P-2	Φ400mm	TIMBER PILE
T.P-3	Φ300mm	TIMBER PILE

AS-CONSTRUCTED



ABN: 12 620 585 391
info@technocrete.com.au
PHONE: 02 60 214 406 MOBILE: 0413 027 015
OFFICE 3 & 4, SUITE 1B, 508 SWIFT ST., ALBURY, NSW, 2640
https://technocrete.com.au

1	26/04/23	AS-CONSTRUCTED DRAWINGS	NH	FN
NO.	DATE	DESCRIPTION	DRAWN	APPROVED
AMENDMENTS AND REVISIONS				

SURVEYED BY	SCALES (A1)
SURVEY FILE No	0 1.5 3m
LEVEL DATUM A.H.D.	1:75
HOR. DATUM / DATE MGA 94/2020	


DRAWN TECHNOCRETE	SIGNED TECHNOCRETE	DATE 26/04/23	ASSET OWNER
DESIGNED TECHNOCRETE	SIGNED TECHNOCRETE	DATE 26/04/23	MACKAY REGIONAL COUNCIL
CHECKED TECHNOCRETE	SIGNED TECHNOCRETE	DATE 26/04/23	CERTIFIED
MANAGER / CO-ORDINATOR			26/04/23
PRINT NAME			DATE
Dr. FARHAD NABAVI & RPEQ 20038			DATE



BALBERRA BRIDGE
MUNBURA RD BALBERRA BRIDGE OVER BELL CK AT CH.6140
(ASSET ID BRDG12287) AS-CONSTRUCTED DRAWINGS


BRIDGE PLAN & ELEVATION

SHEET 2 OF 5	
WORKS JOB No.	TC22-P330
DRAWING No.	AMEND.
S01	1

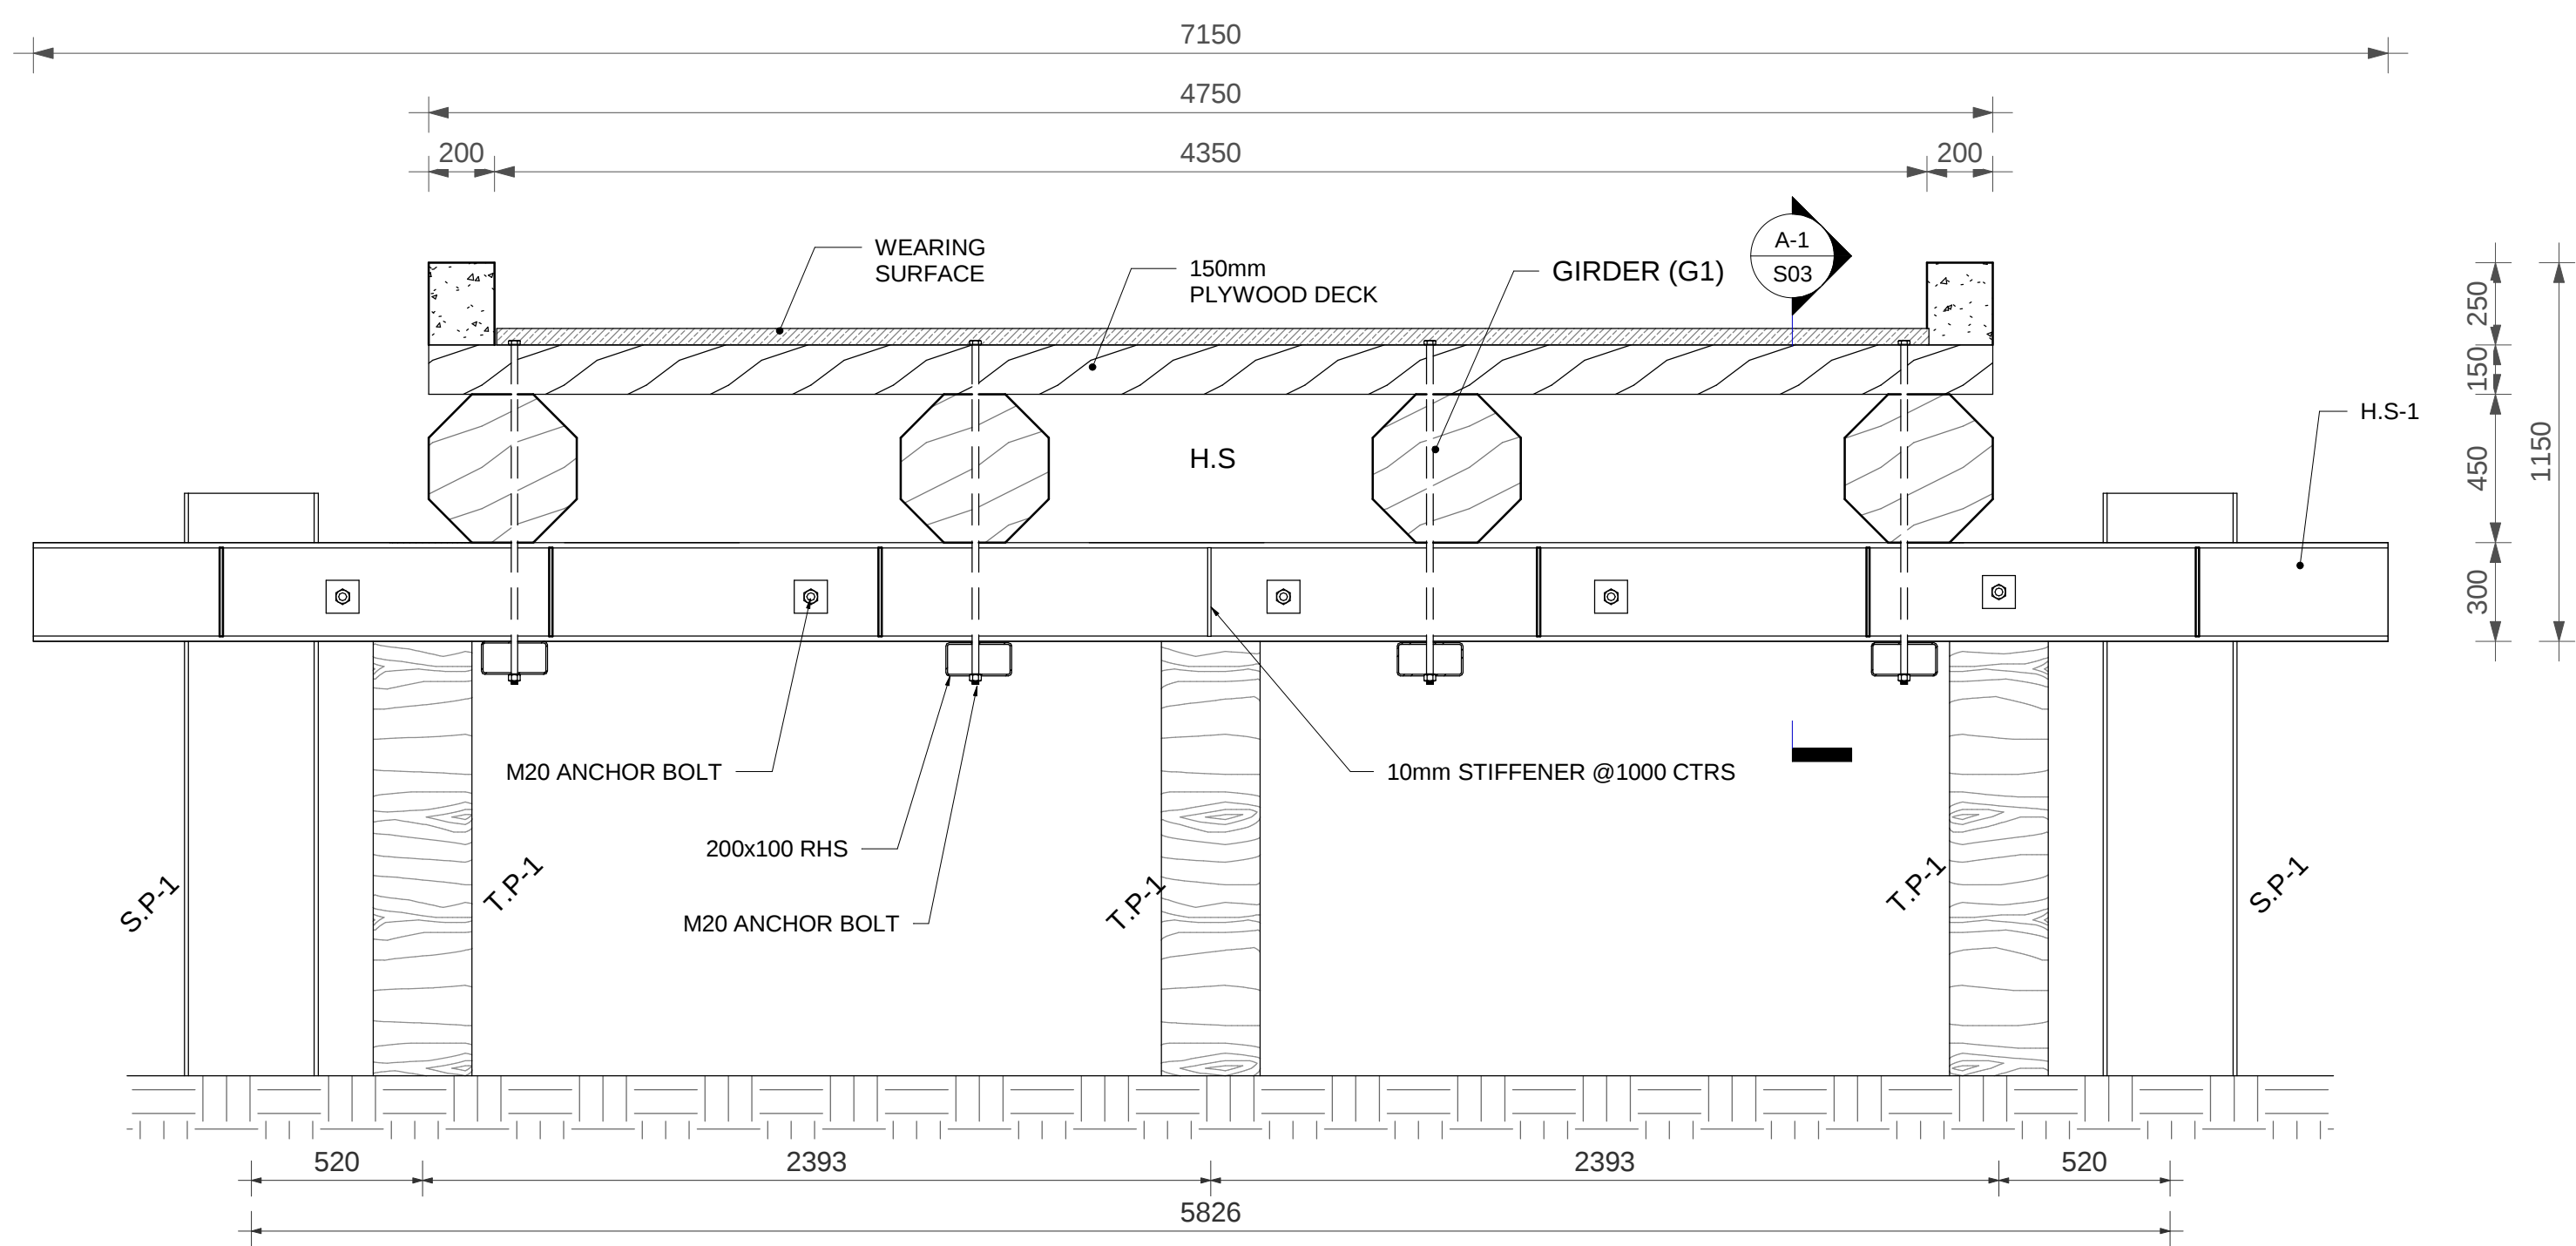


ABUTMENT 'A1' ELEVATION

SECTION A
SCALE: 1:20
S01

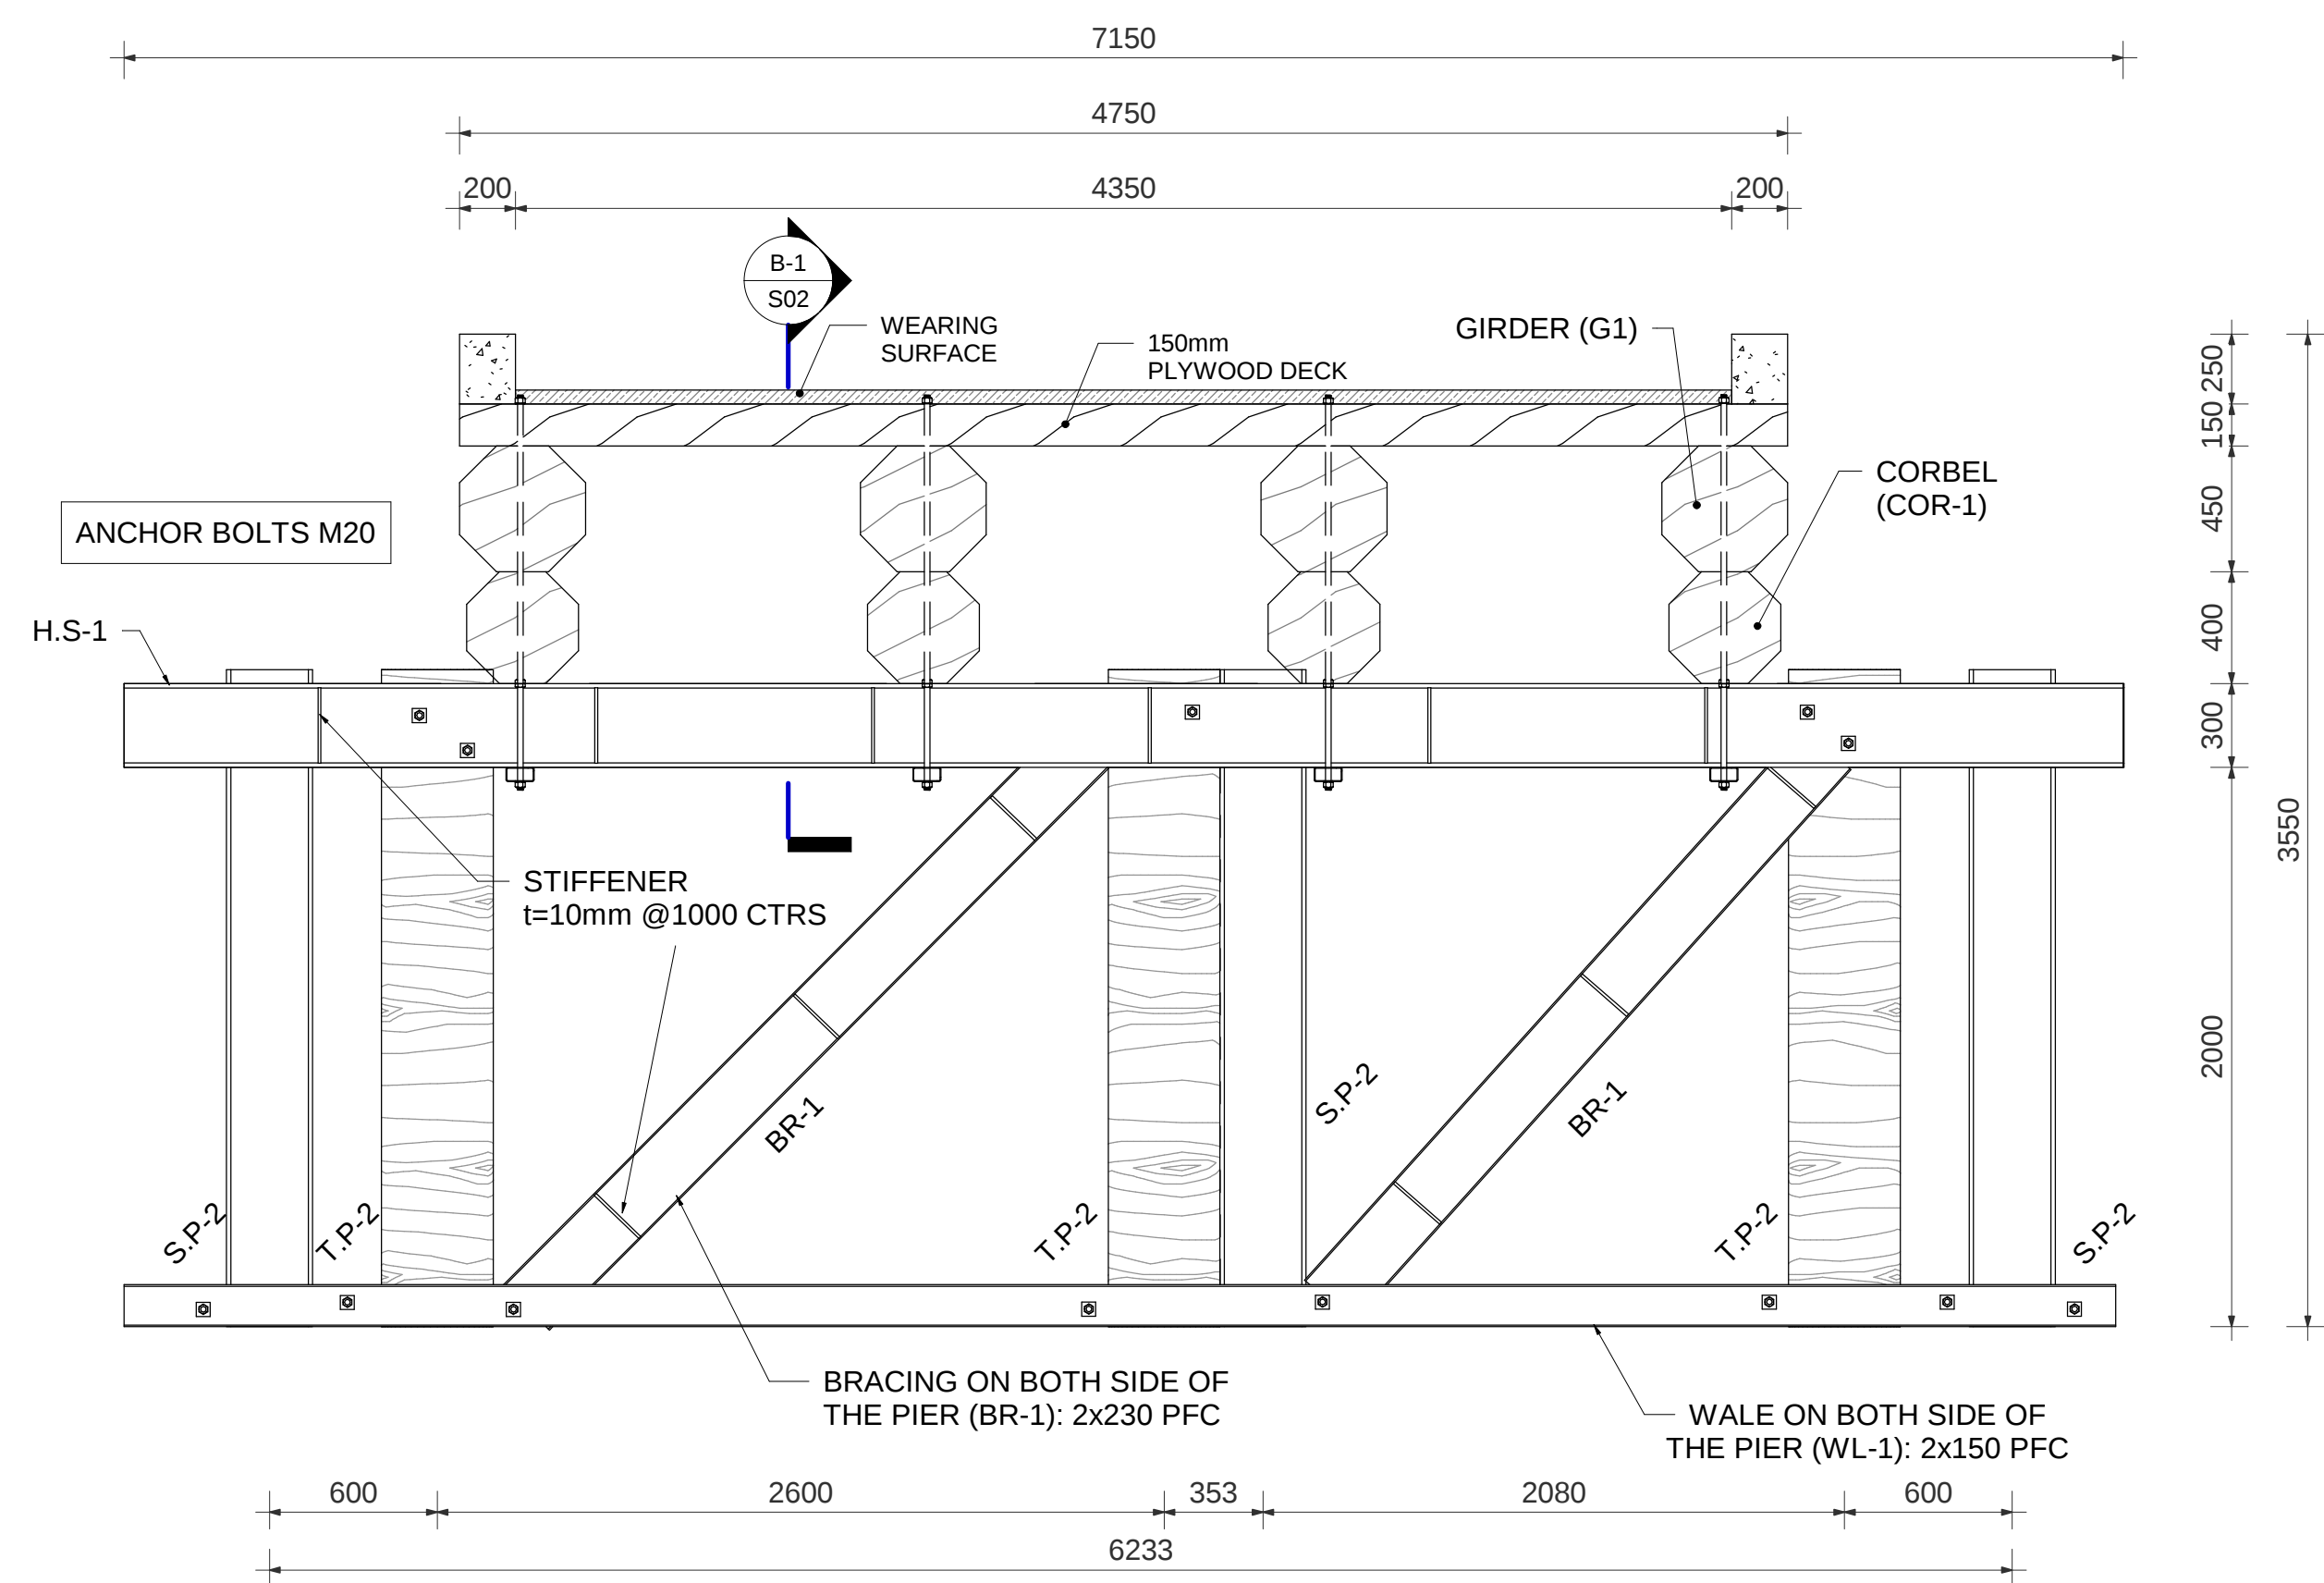


PIER 'P1' ELEVATION

SECTION B
SCALE: 1:25
S01

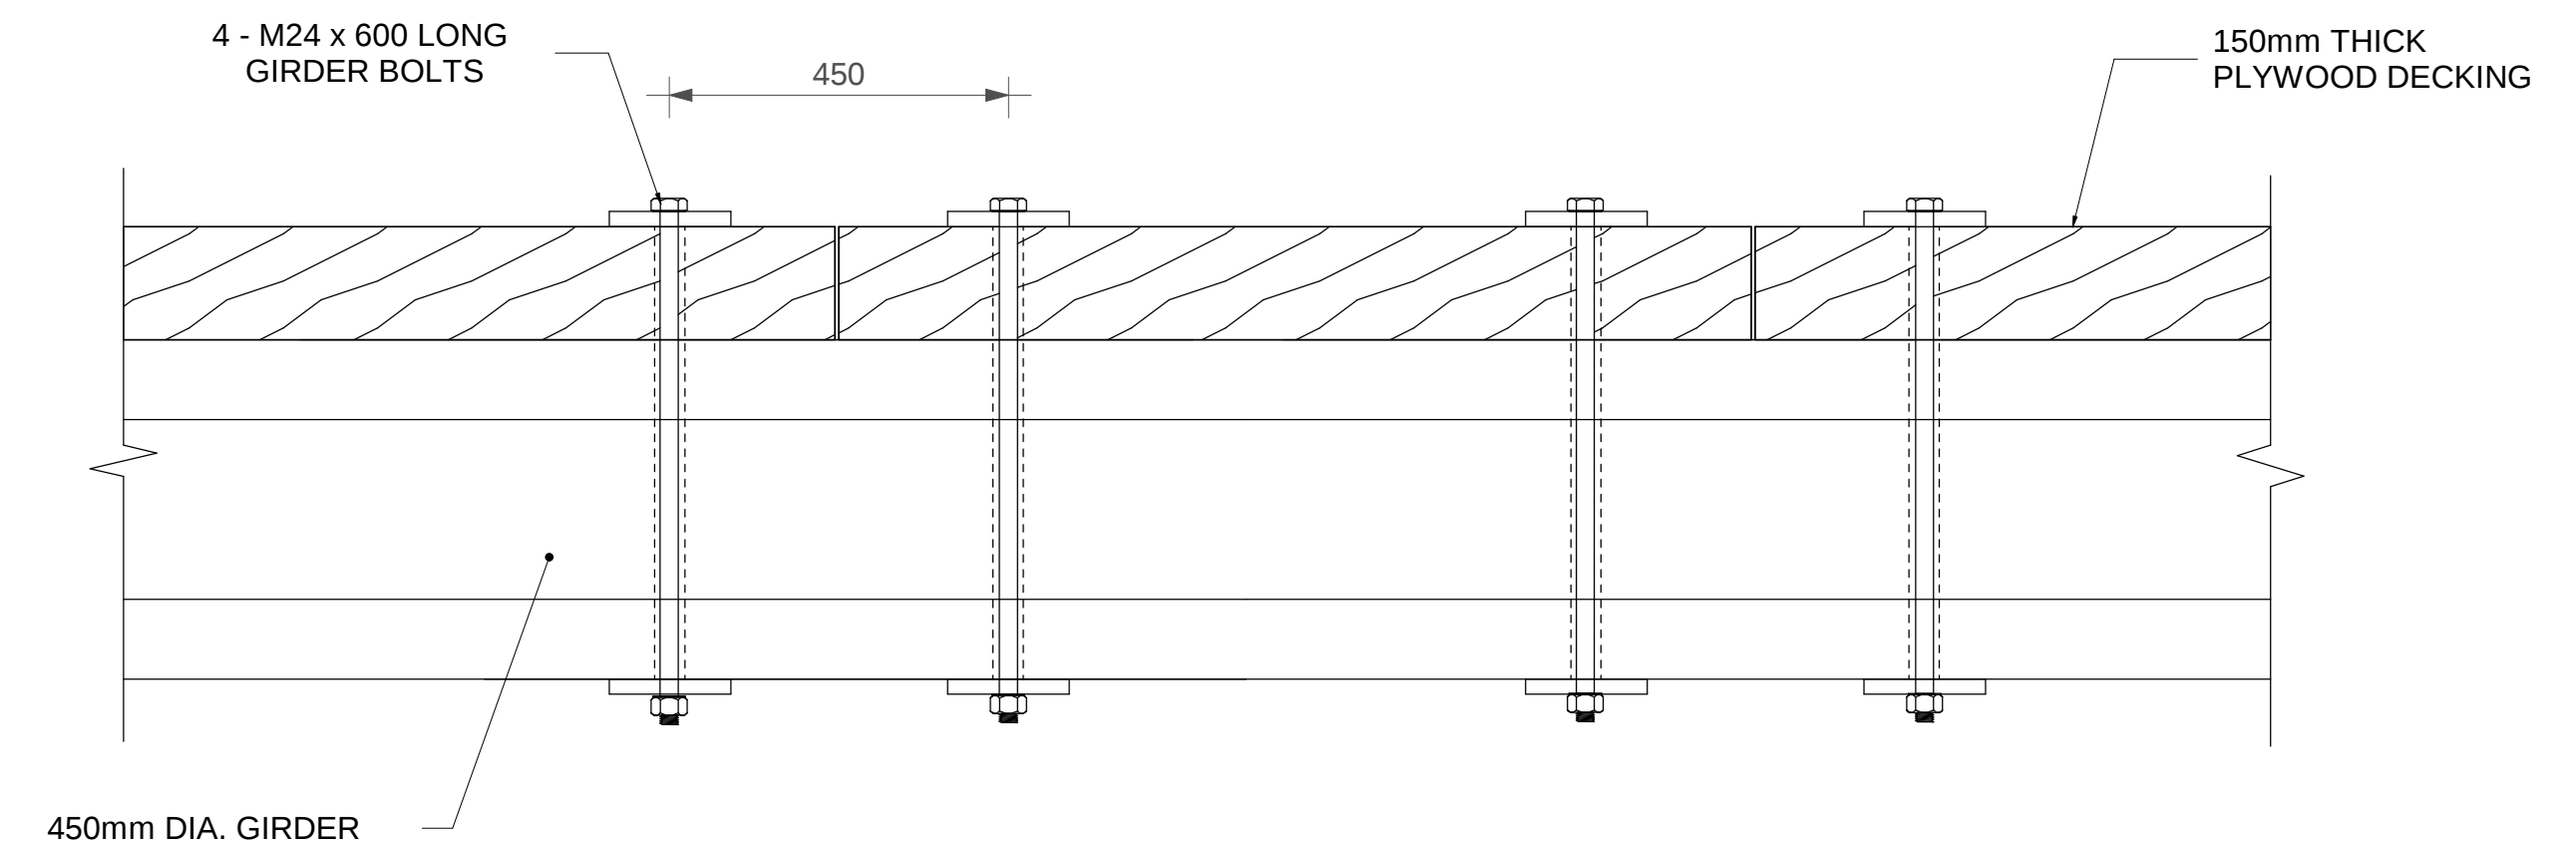

GIRDER - DECK CONNECTION

SCALE 1:10

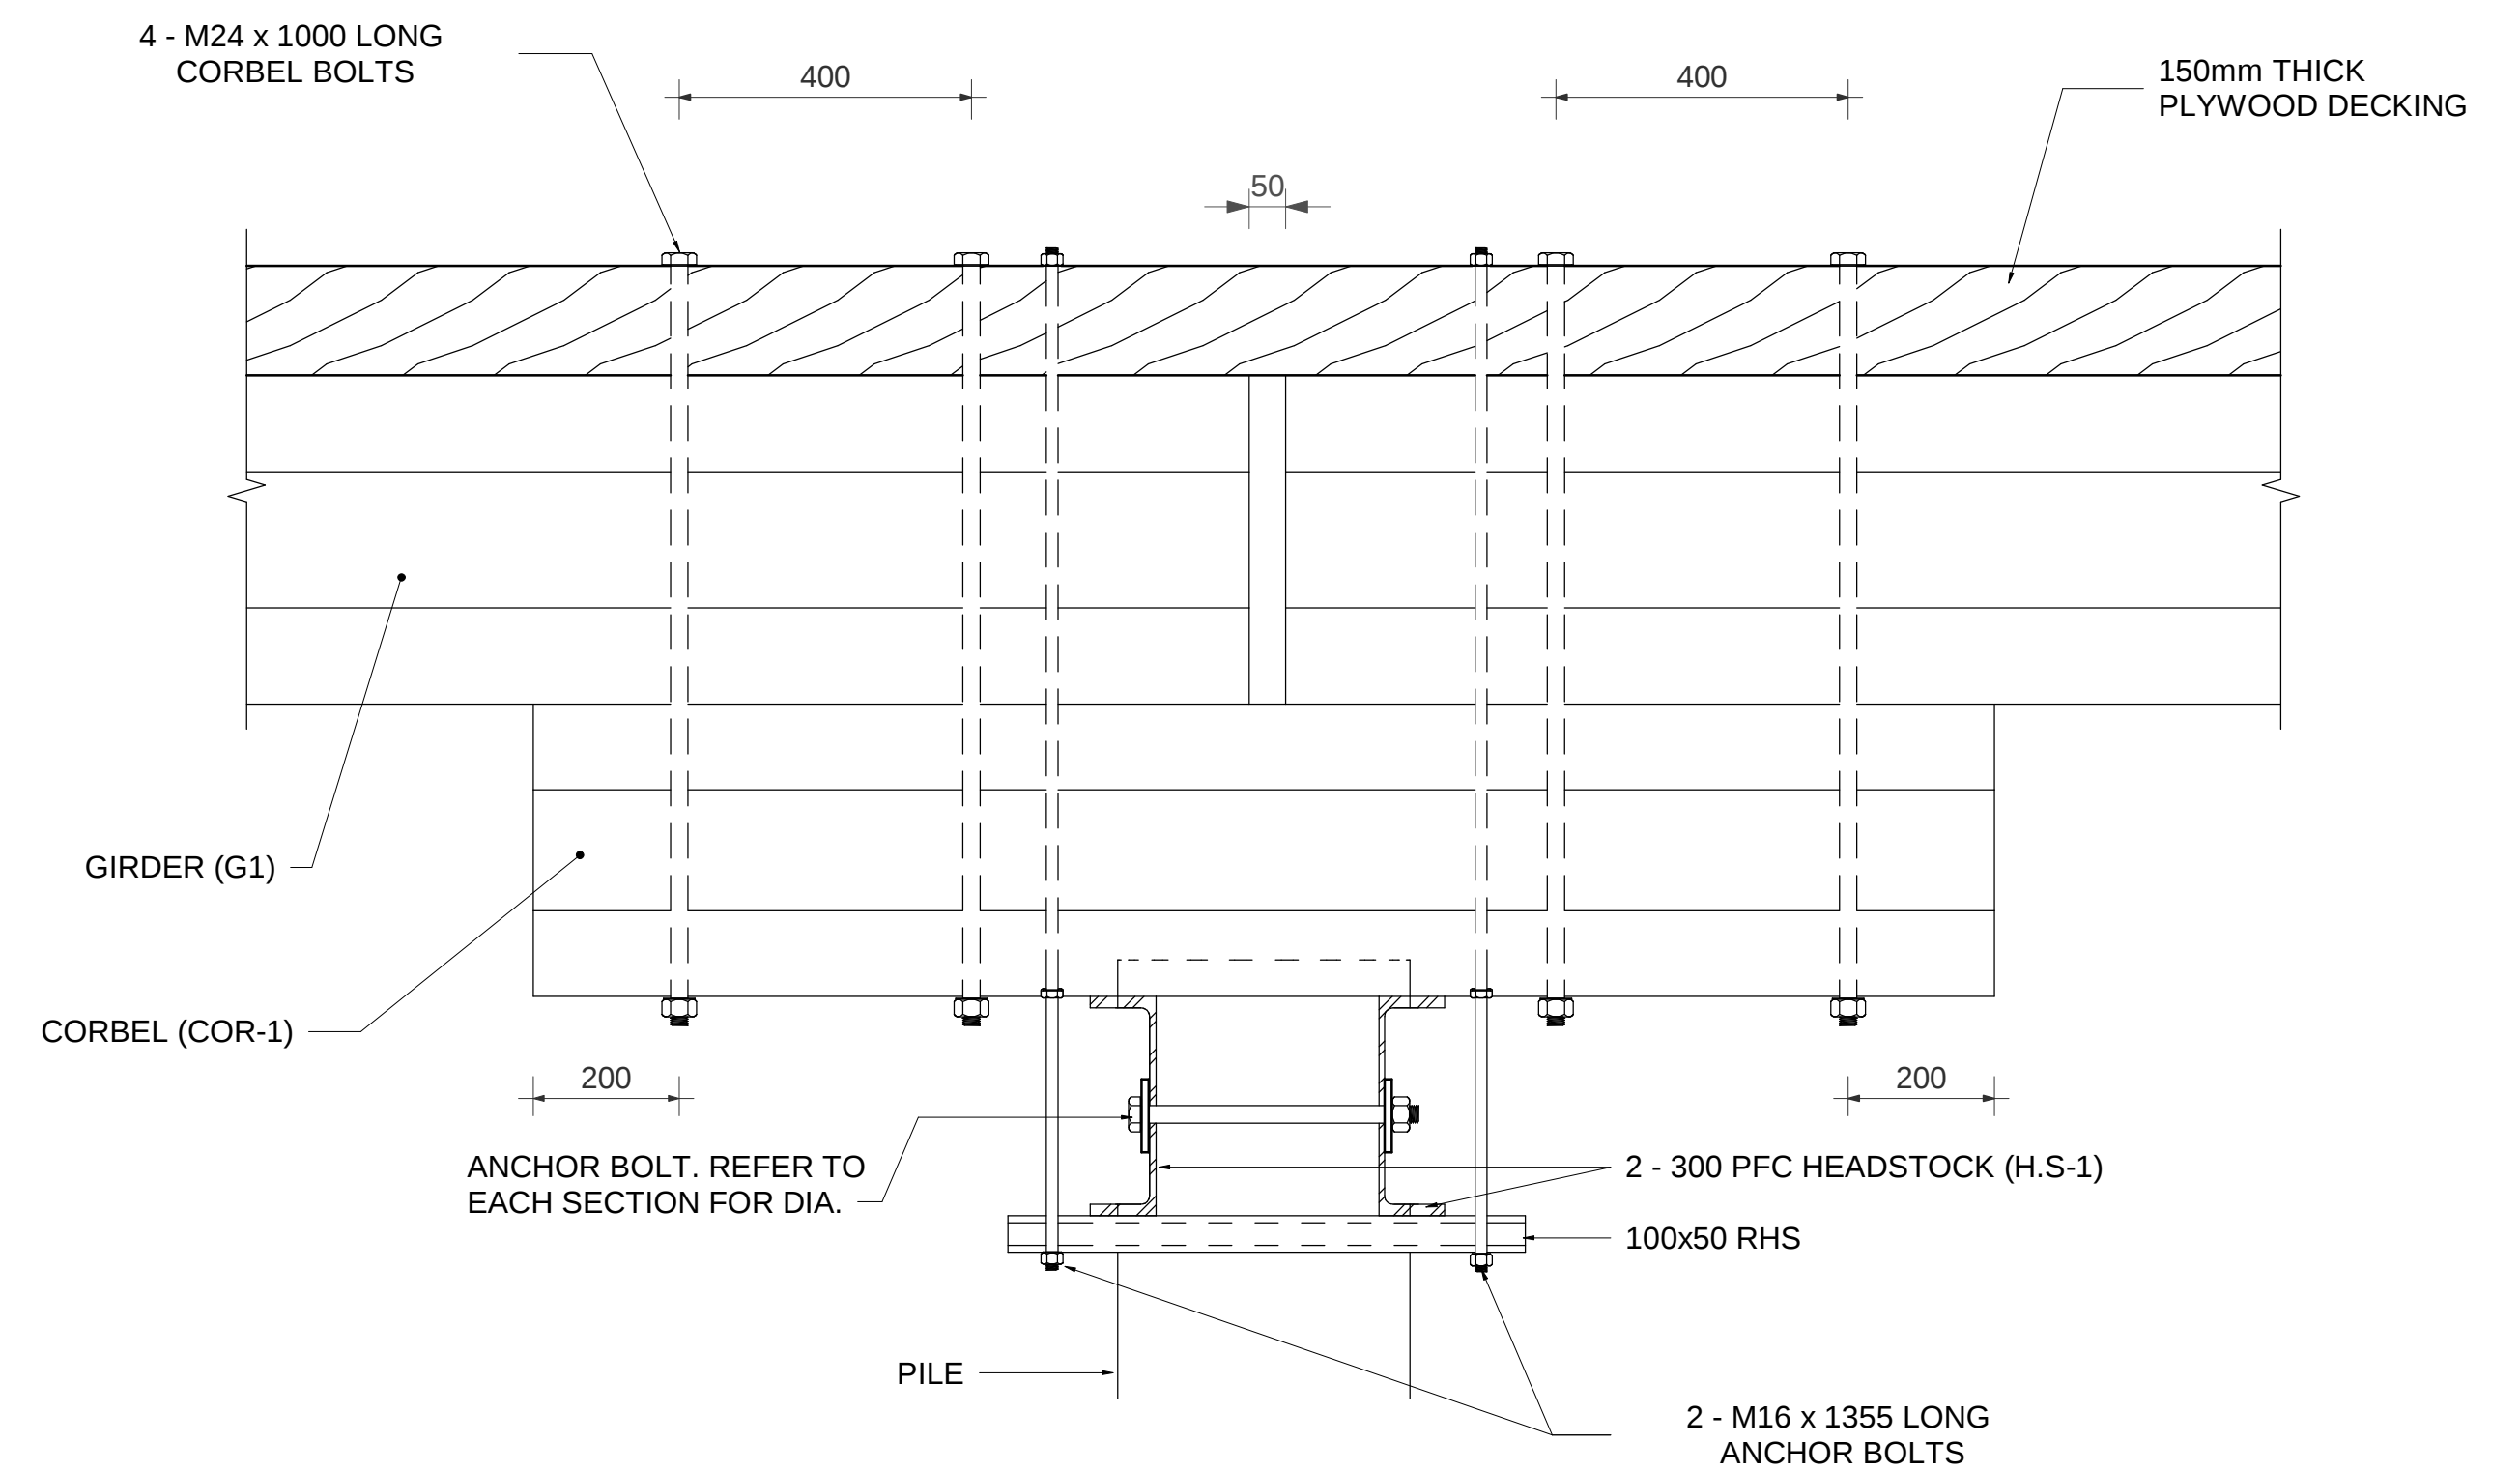

PIER - DECK CONNECTION


SECTION B-1
SCALE: 1:10
S02

AS-CONSTRUCTED




ABN: 12 620 585 391
info@technocrete.com.au
PHONE: 02 60 214 406 MOBILE: 0413 027 015
OFFICE 3 & 4, SUITE 1B, 508 SWIFT ST., ALBURY, NSW, 2640
https://technocrete.com.au

																																																																																																																																																																																																																																																																																																																																																																																																																																																																																																																																																																																																																																																																																																																																																																																																																																																																																																																																																																																																																																																																																																																																																																																																																																																																																																																																																																																																																																																																									</
--	--	----

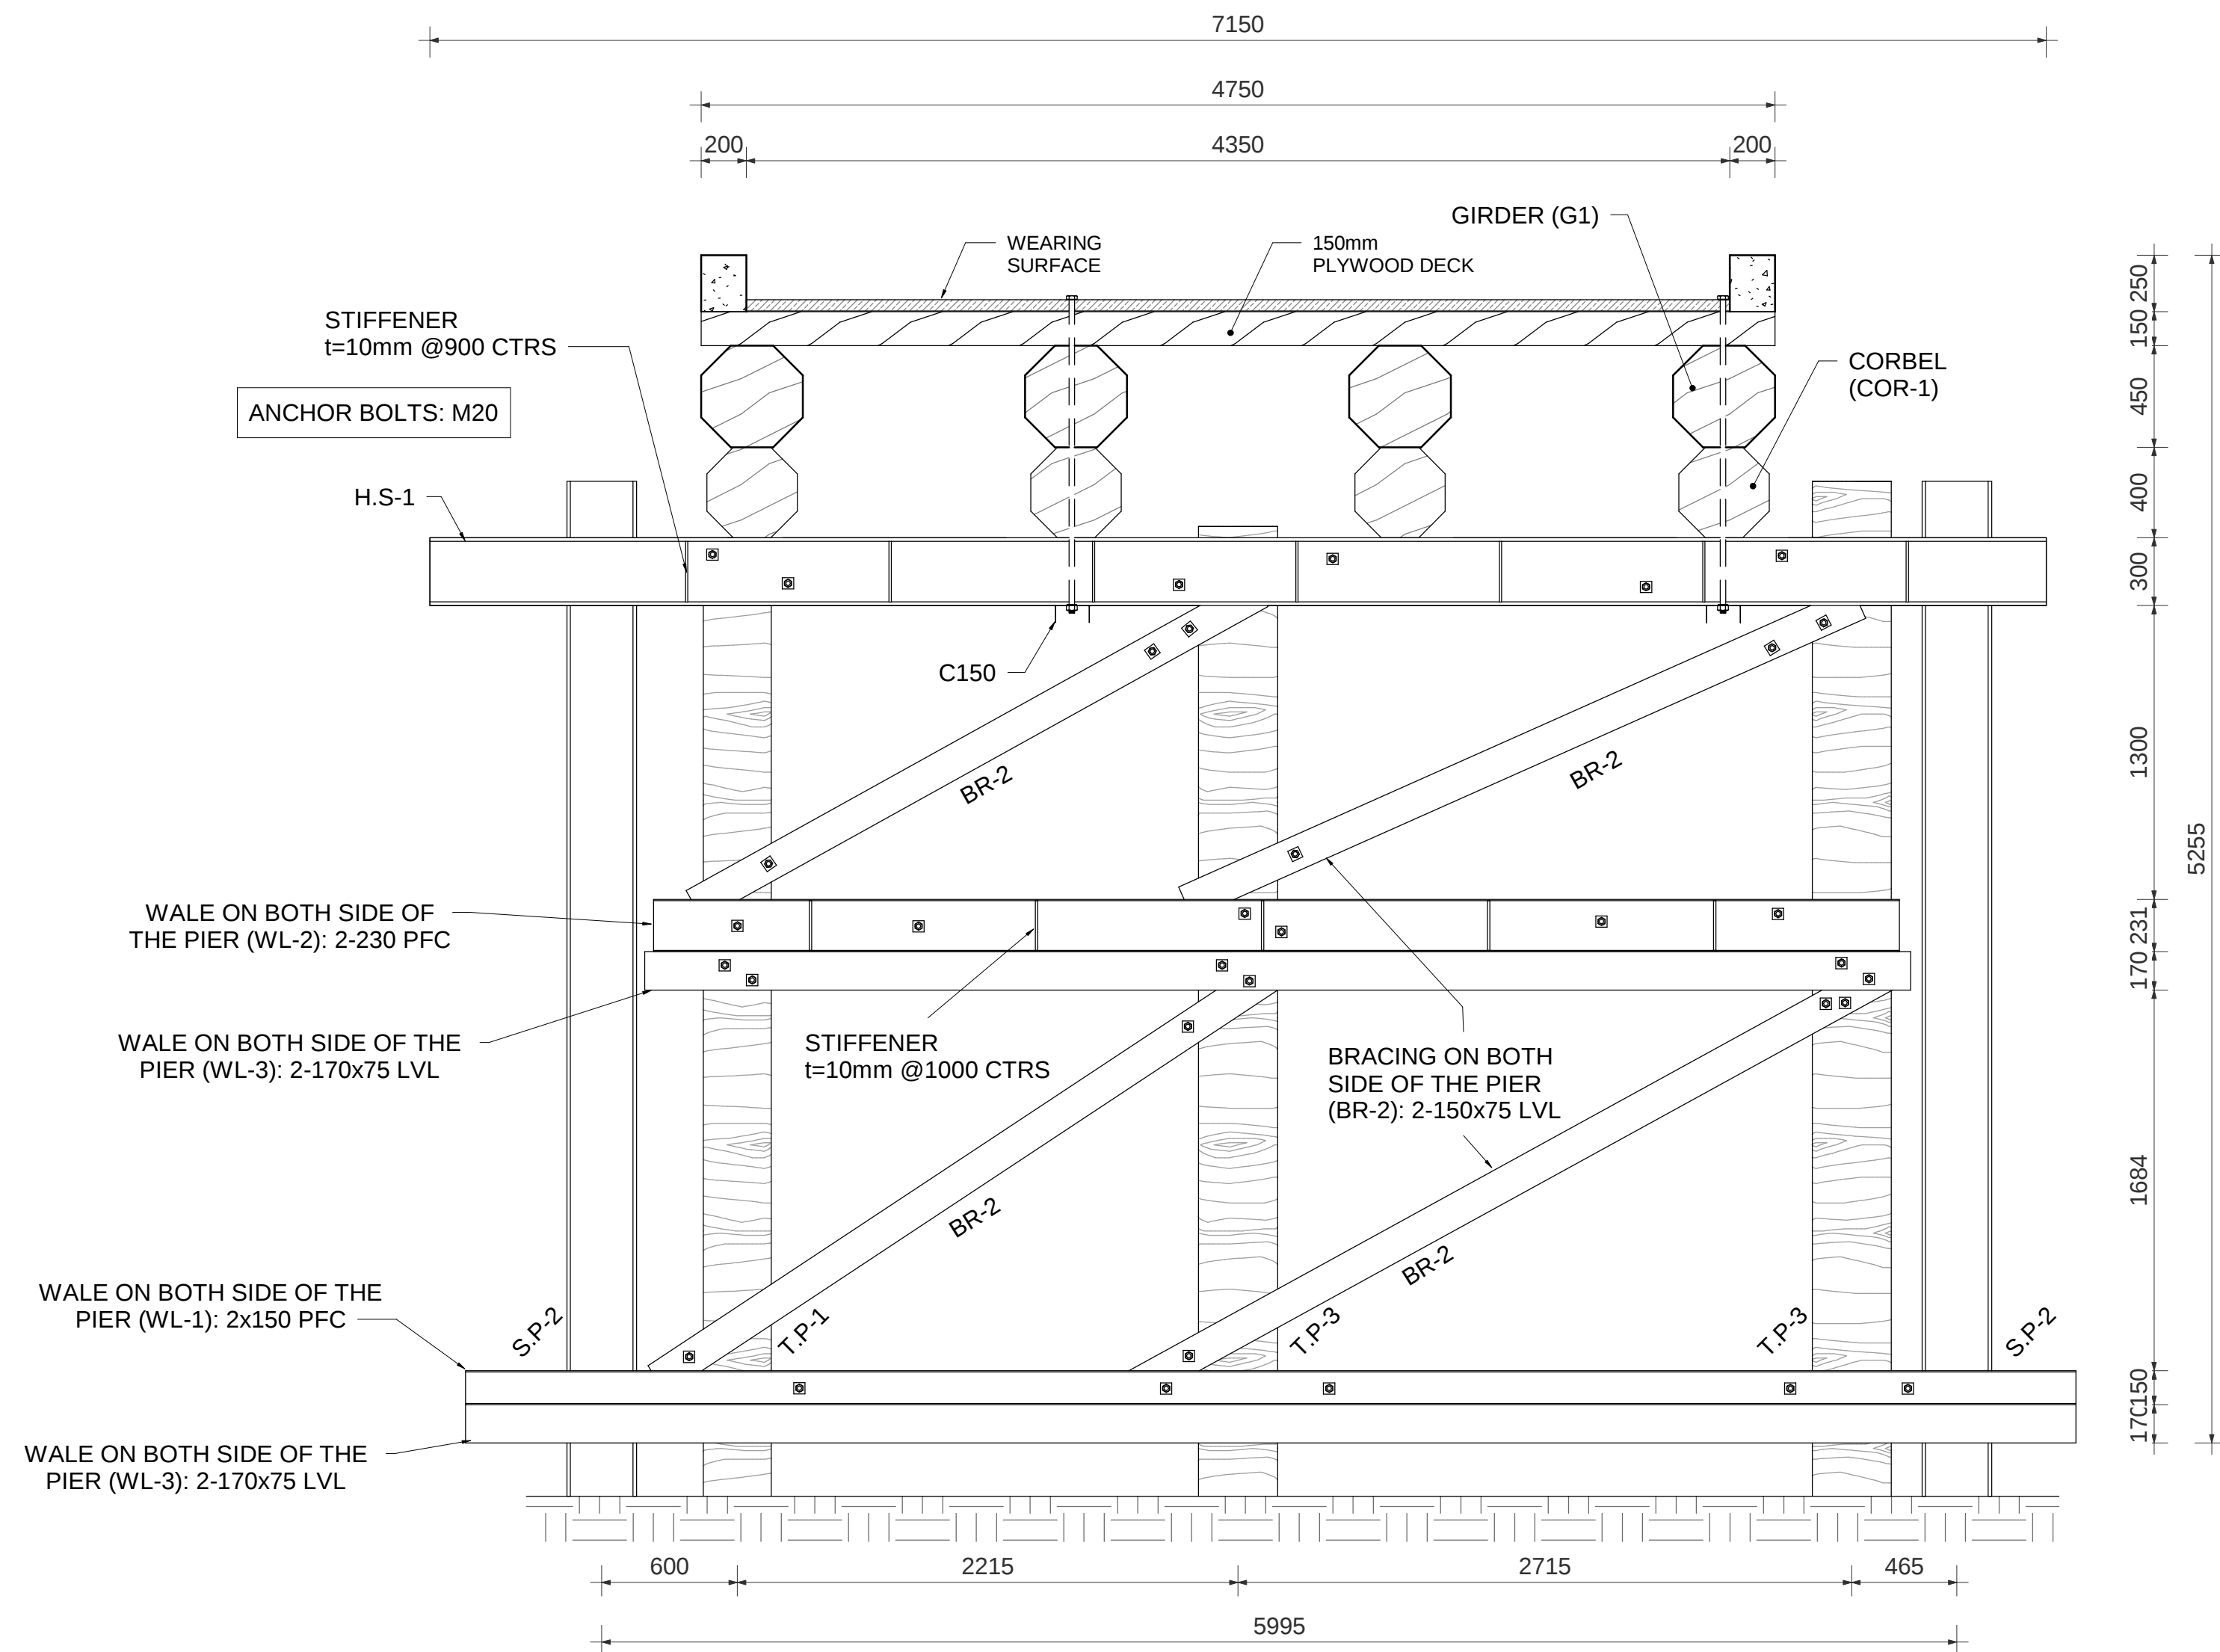


SECTION C
SCALE: 1 : 25
S01

PIER 'P2' ELEVATION

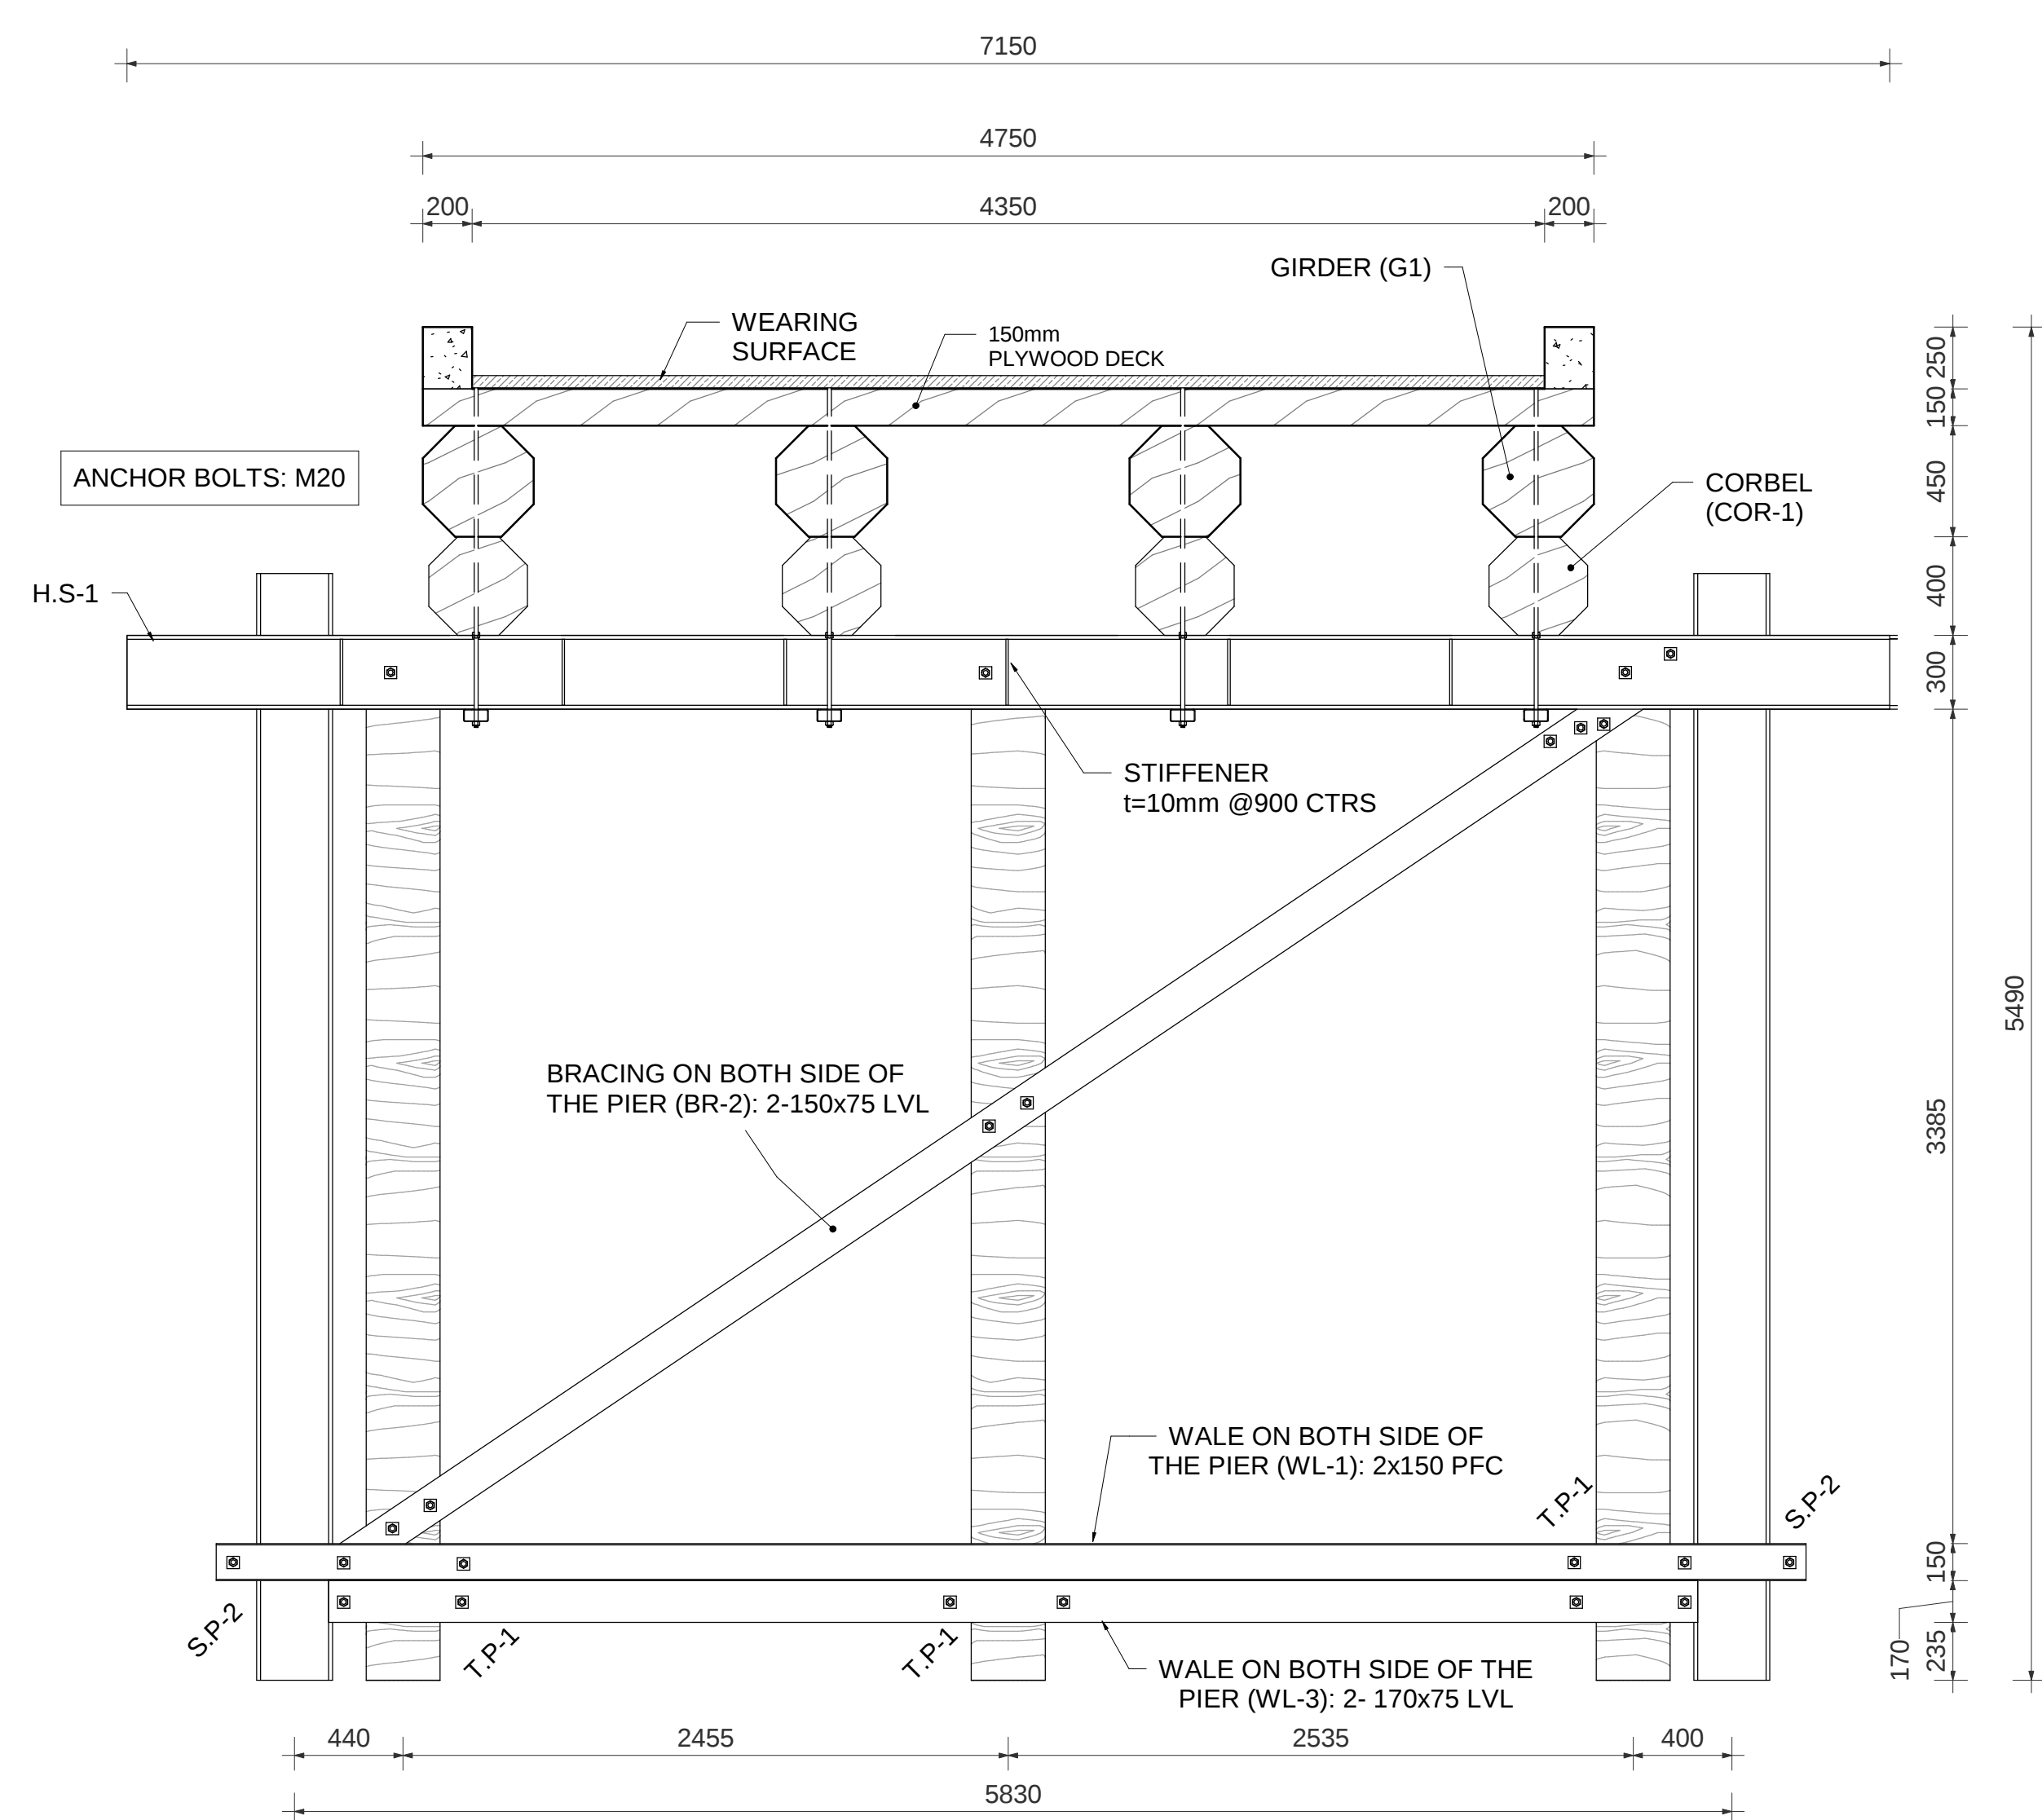

SECTION D
SCALE: 1 : 25
S01

PIER 'P3' ELEVATION

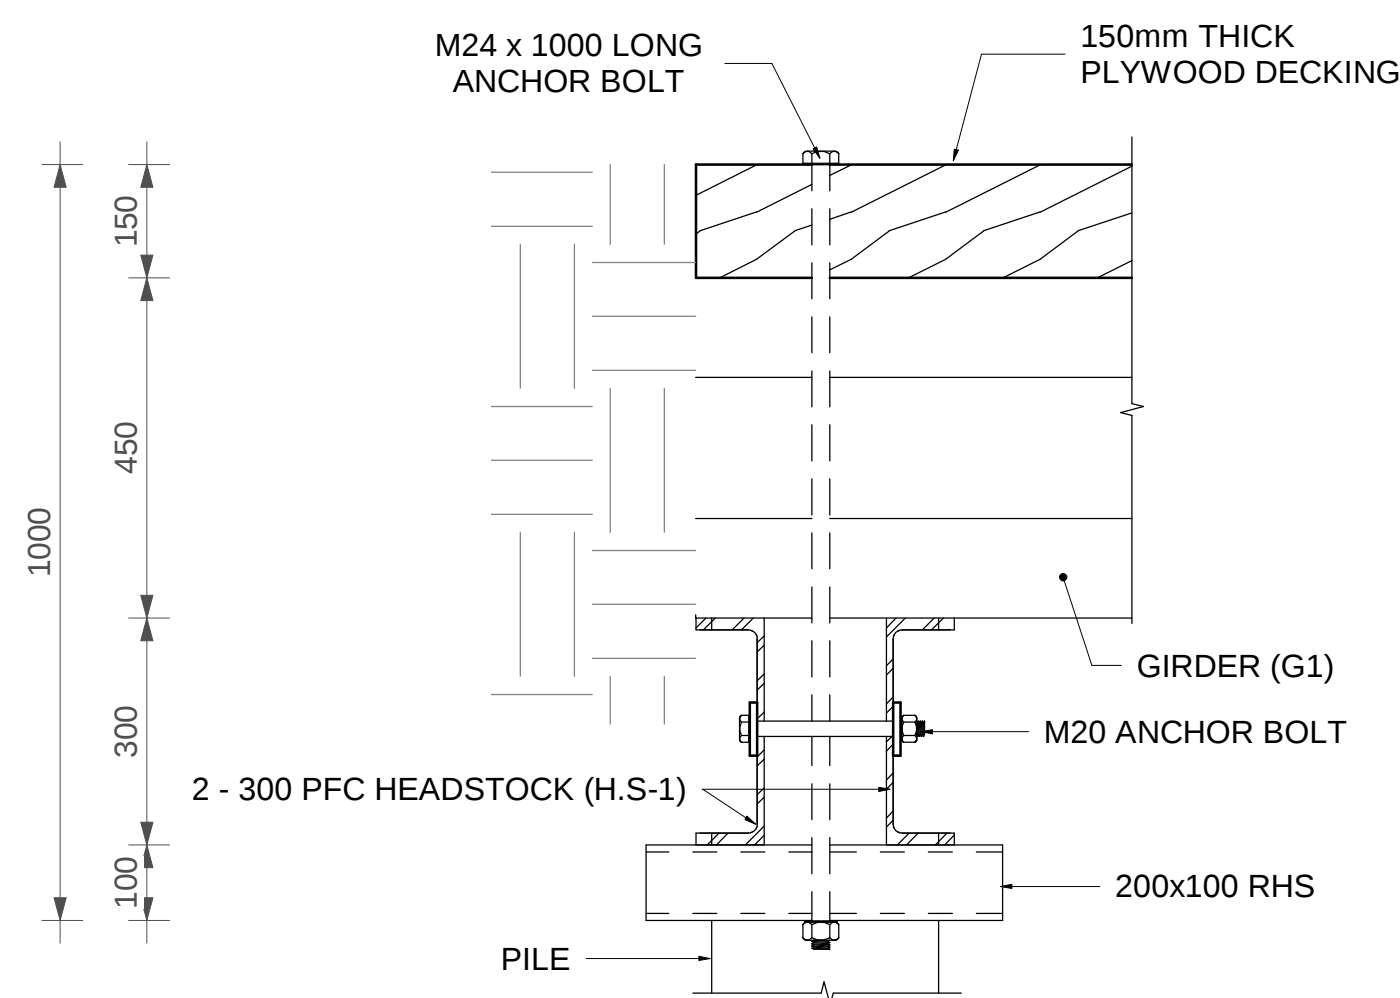

ABUTMENT 'A1' TO DECK CONNECTION

SECTION A-1
SCALE: 1 : 10
S02

AS-CONSTRUCTED



ABN: 12 620 585 391
info@technocrete.com.au
PHONE: 02 60 214 406 MOBILE: 0413 027 015
OFFICE 3 & 4, SUITE 1B, 508 SWIFT ST,
ALBURY, NSW, 2640
https://technocrete.com.au

--	--	
